
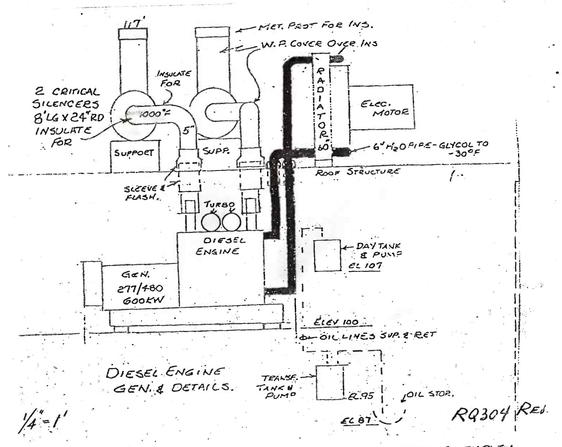



DIESEL ENGINE GEN. & DETAILS.

1/4"=1'


RQ304 Rev.

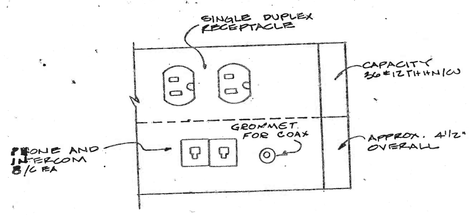



2 DUCT SURFACE RACEWAY SHERIFFS DEPARTMENT

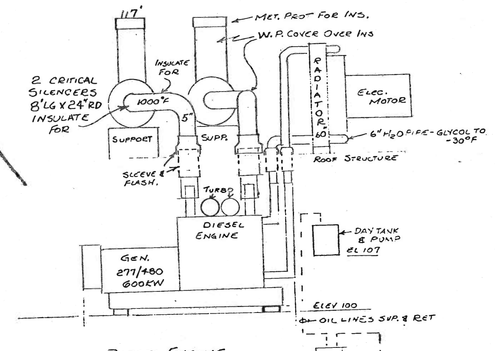


DIESEL ENGINE GEN. & DETAILS.

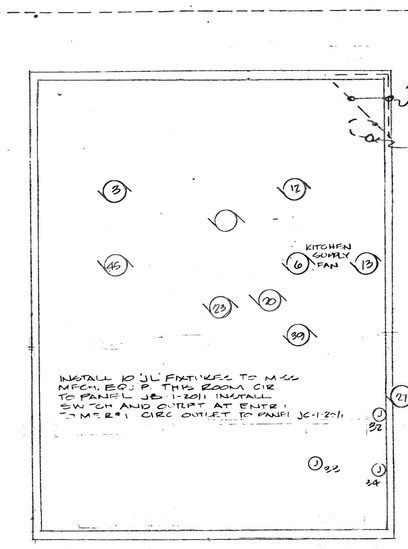

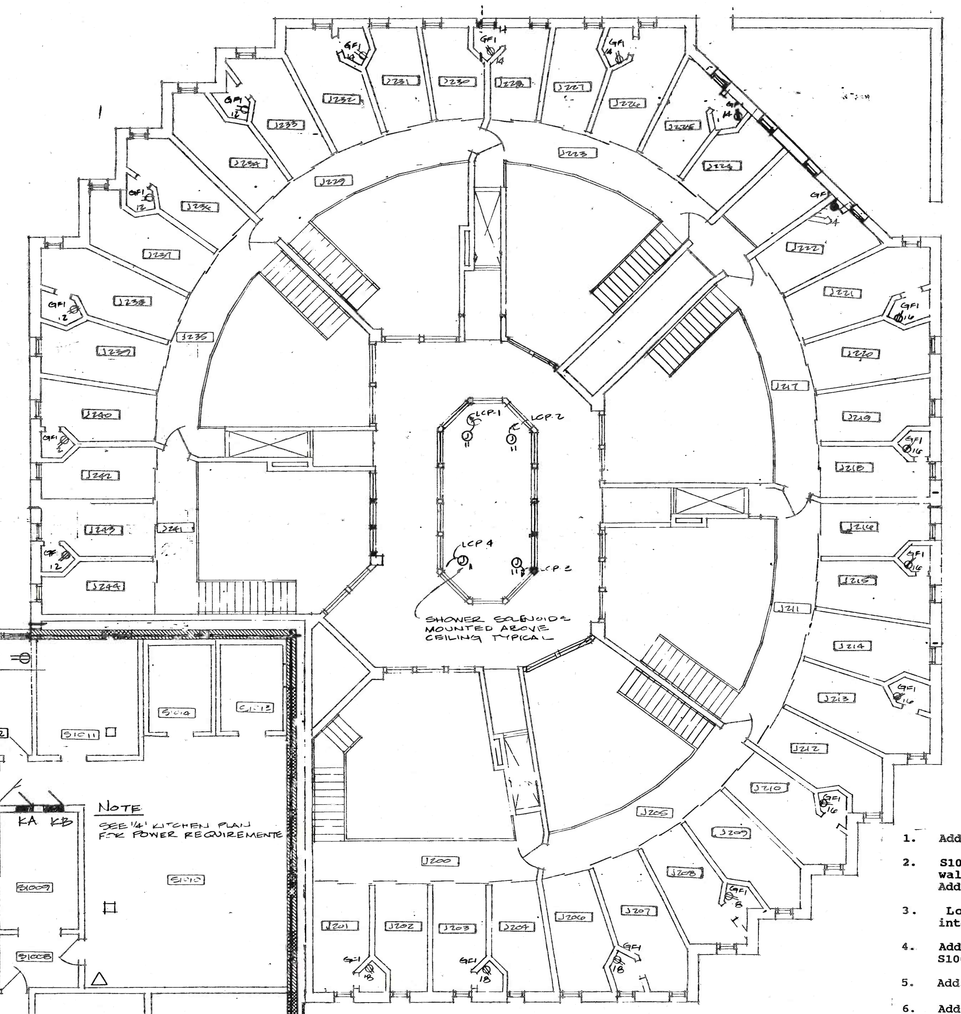

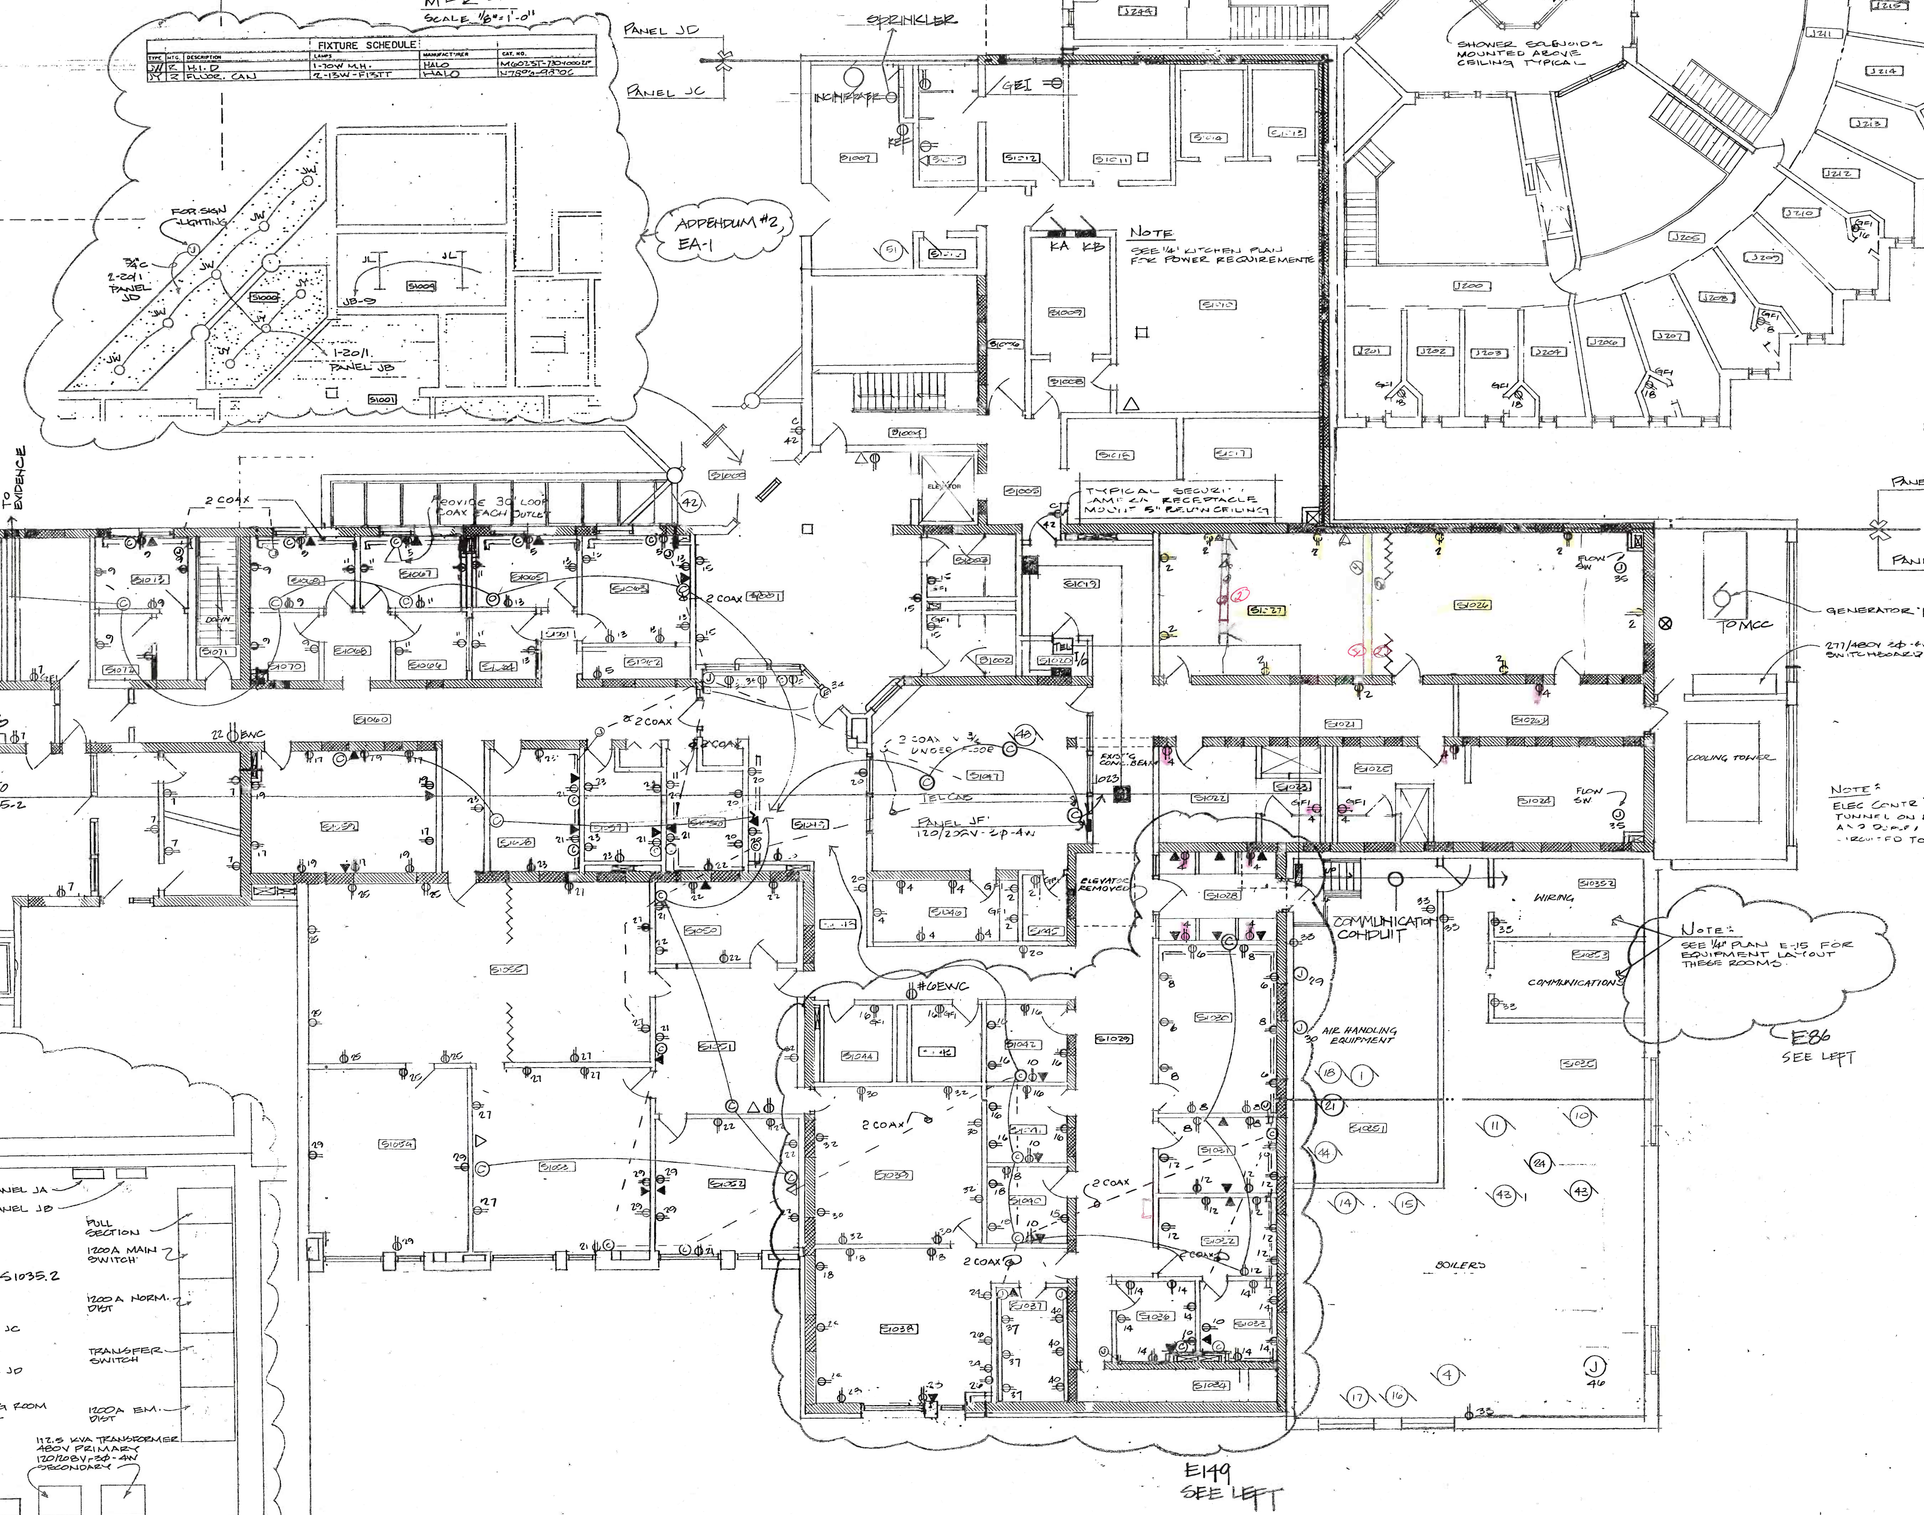

1. Add 'GFI' receptacle adjacent to sink in Room S1015.
2. S1047 - Add 1 receptacle on East wall 12' 0" off South wall. Add 1 receptacle on North wall above counter. Add 1 receptacle on West wall 9' 0" off North wall.
3. Louver in generator room to be motorized and interlocked with generator.
4. Add receptacle and telephone jack on East wall of Room S1001 adjacent to door for public telephone.
5. Add receptacle for EWC corridor S1048.
6. Add connections for incinerator in Room J093.

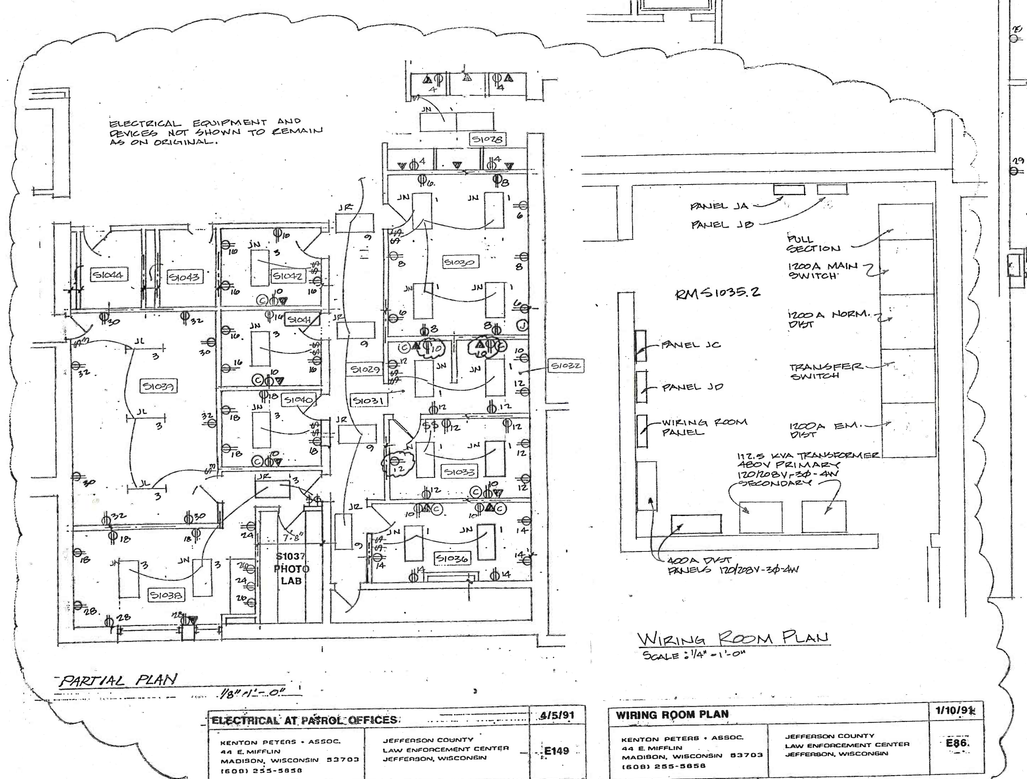

ELECTRICAL AT PATROL OFFICES		6/5/91
KENTON PETERS + ASSOC. 44 E. MIFFLIN MADISON, WISCONSIN 53703 (608) 255-5656	JEFFERSON COUNTY LAW ENFORCEMENT CENTER JEFFERSON, WISCONSIN	E149

WIRING ROOM PLAN		1/10/95
KENTON PETERS + ASSOC. 44 E. MIFFLIN MADISON, WISCONSIN 53703 (608) 255-5656	JEFFERSON COUNTY LAW ENFORCEMENT CENTER JEFFERSON, WISCONSIN	E86

DATE	REVISION

STRUCTURAL CONSULTANT

MECHANICAL CONSULTANT
MDI 1910 MAYFLOWER DR. MIDDLETON, WI. 608-836-7600

ARCHITECT
KENTON PETERS + ASSOC., INC.
44 E MIFFLIN
MADISON, WISCONSIN 53703
(608) 255-5656

JEFFERSON COUNTY
LAW ENFORCEMENT CENTER
JEFFERSON, WISCONSIN

FIRST FLOOR PLAN — 6-11-90
1/8"=1'-0" — E-6
POWER, COMM. & DATA

PLAN NORTH

AS BUILT
DEC 6, 1994