
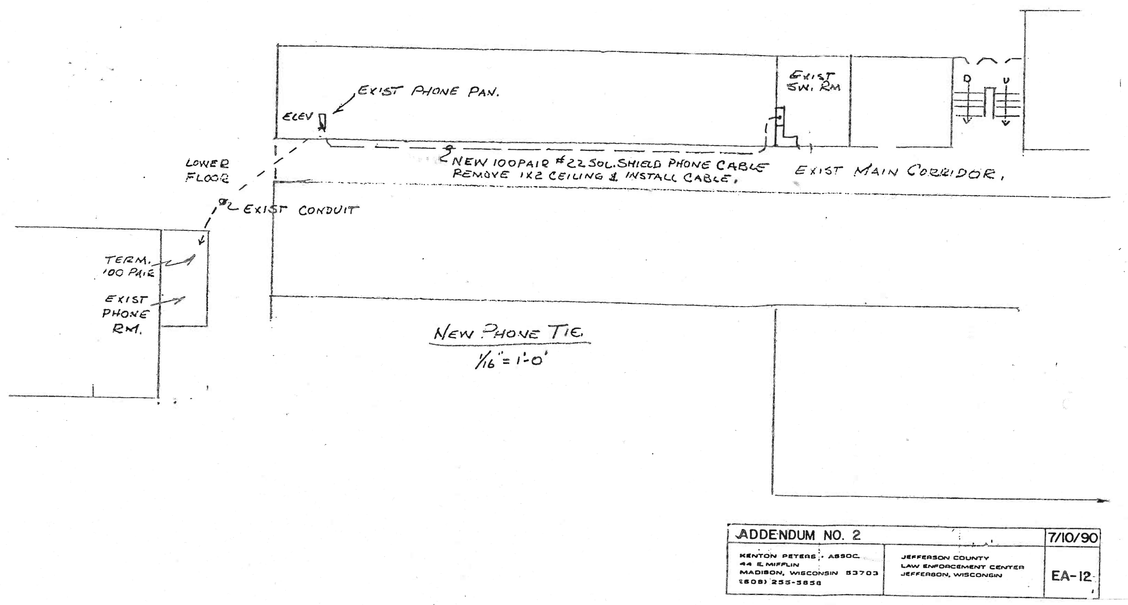


ADDENDUM NO. 2		7/10/90
KENTON PETERS + ASSOC. 44 E. MIFFLIN MADISON, WISCONSIN 53703 (608) 255-5656	JEFFERSON COUNTY LAW ENFORCEMENT CENTER JEFFERSON, WISCONSIN	EA-12

1. Add clock receptacle on South wall 4' 0" off East wall in Room C1106.
2. Relocate clock receptacle on East wall to 12' 0" off South chase wall.
3. All clocks to be mounted at 7' 0" AFF.
4. Master clock to be located in Room S1047.

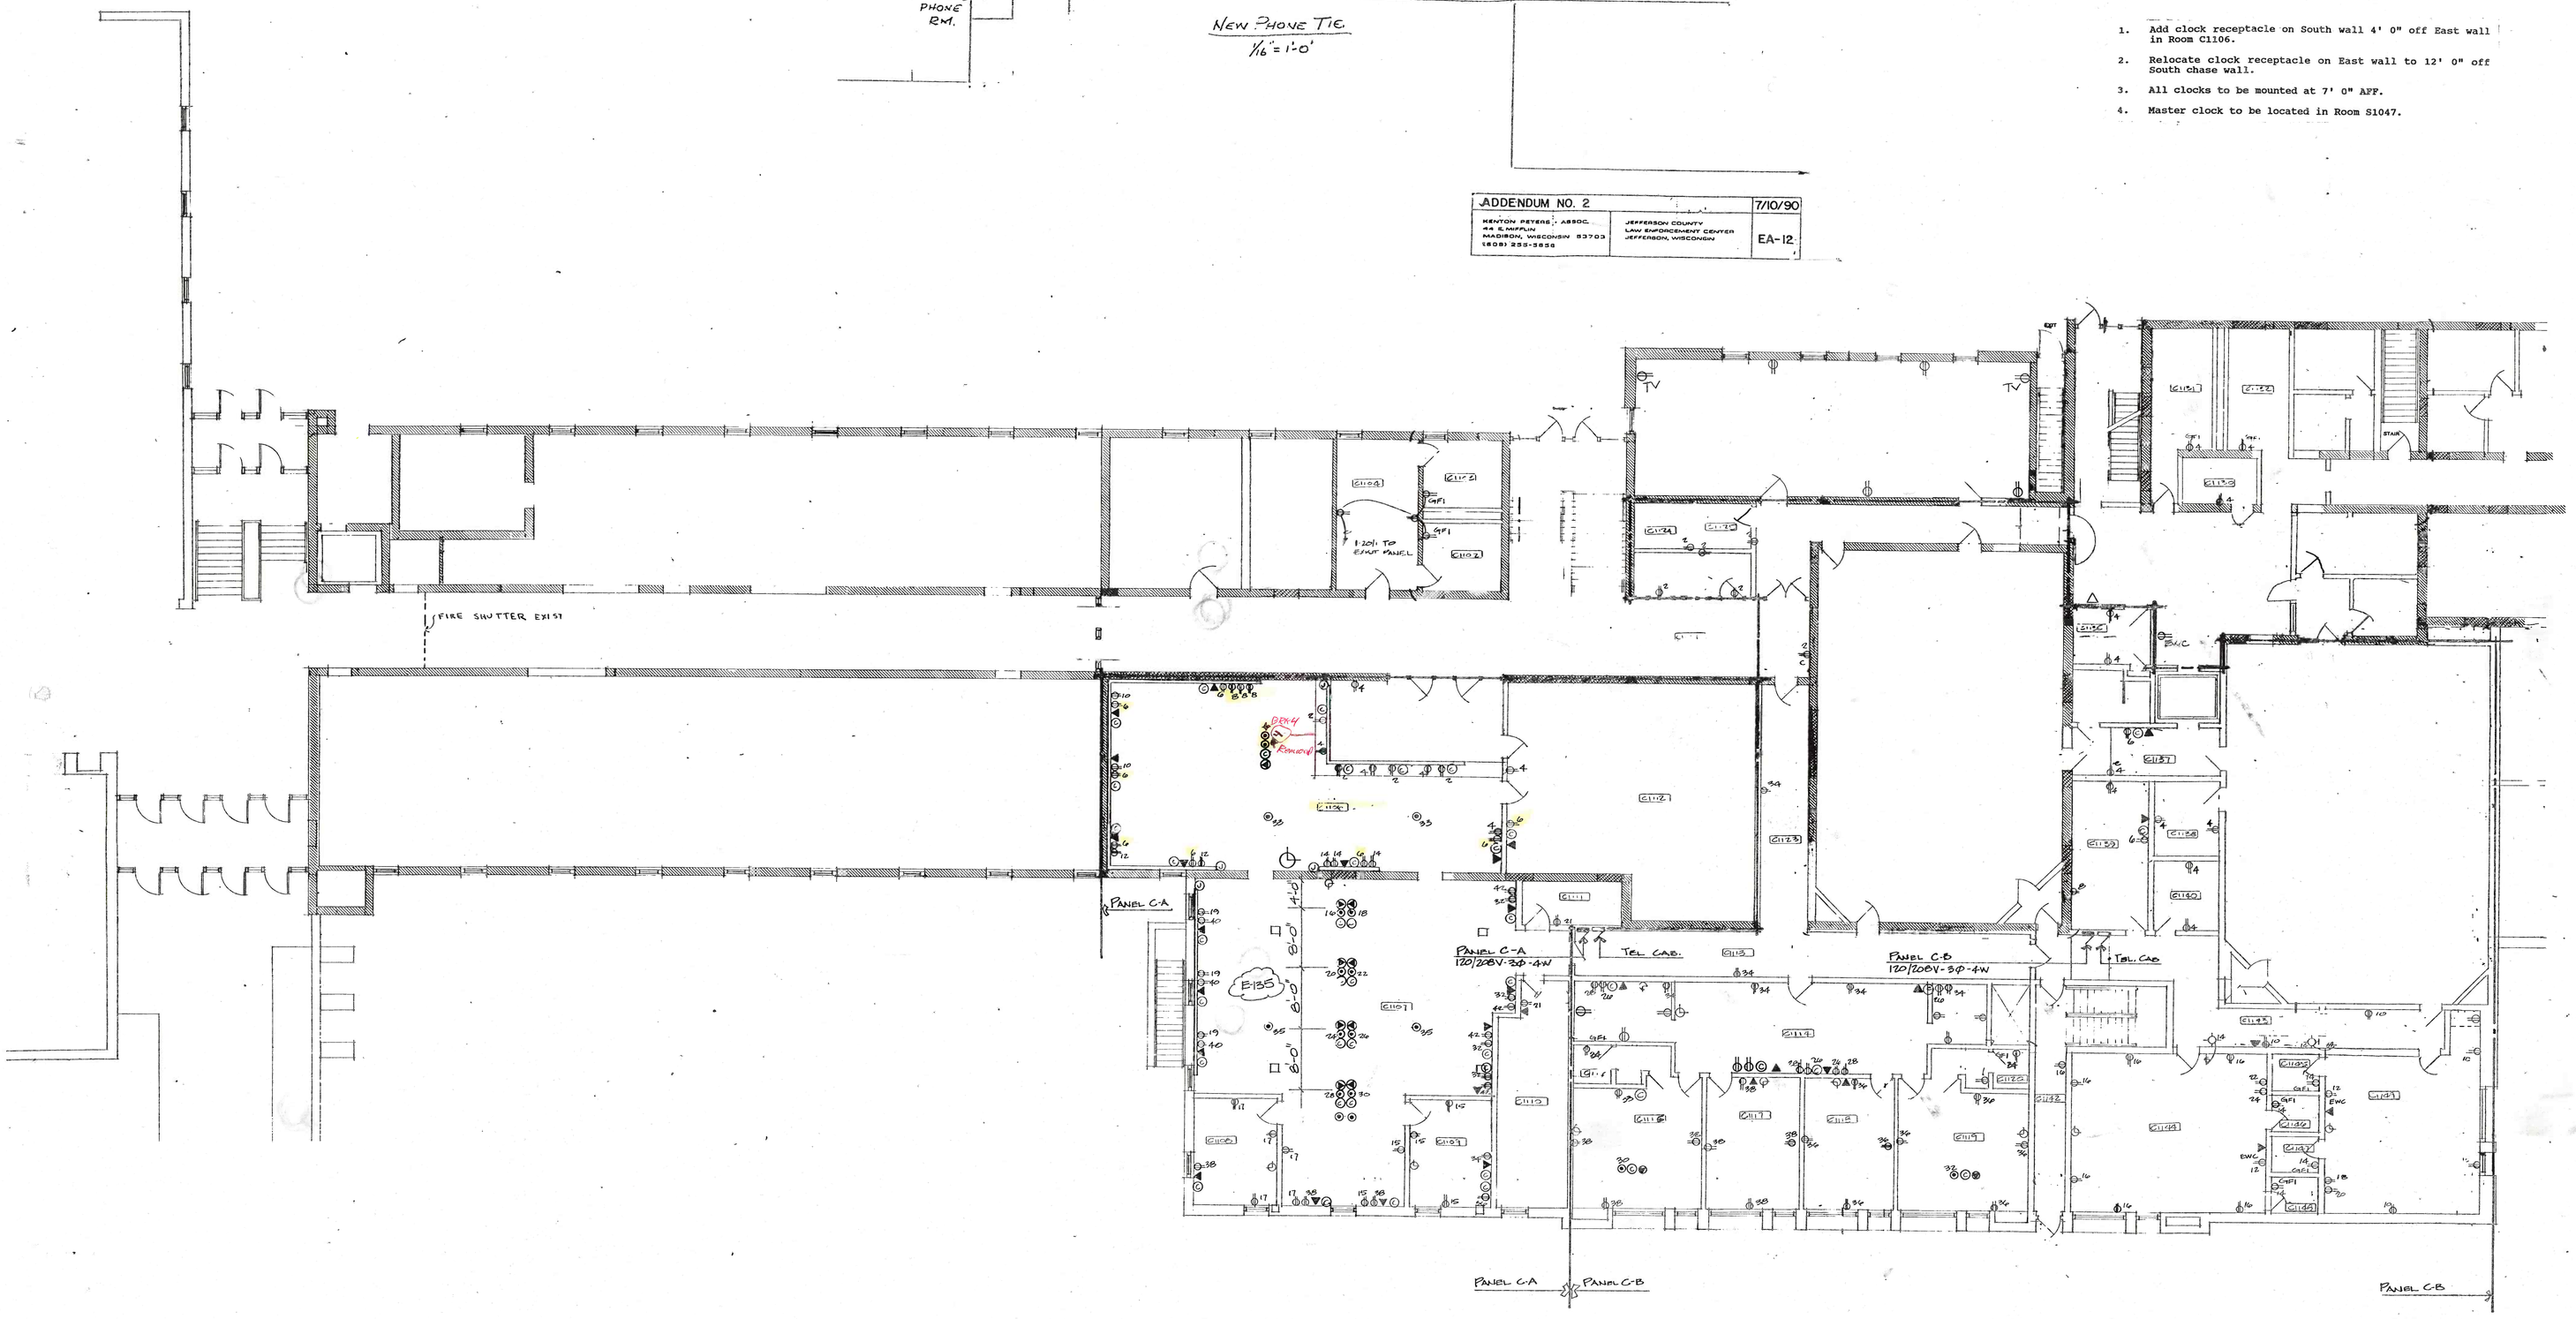

PLAN NORTH

AS BUILT
DEC 6, 1994

STRUCTURAL CONSULTANT

MECHANICAL CONSULTANT.
MDI 1910 MAYFLOWER DR. MIDDLETON, WI.
608-836-7600

ARCHITECT
KENTON PETERS + ASSOC., INC.
44 E MIFFLIN
MADISON, WISCONSIN 53703
(608) 255-5656

JEFFERSON COUNTY
LAW ENFORCEMENT CENTER
JEFFERSON, WISCONSIN

FIRST FLOOR PLAN
COURTHOUSE
1/8"-1'-0"
PWR., DATA, COMM.

6-11-90

E-7