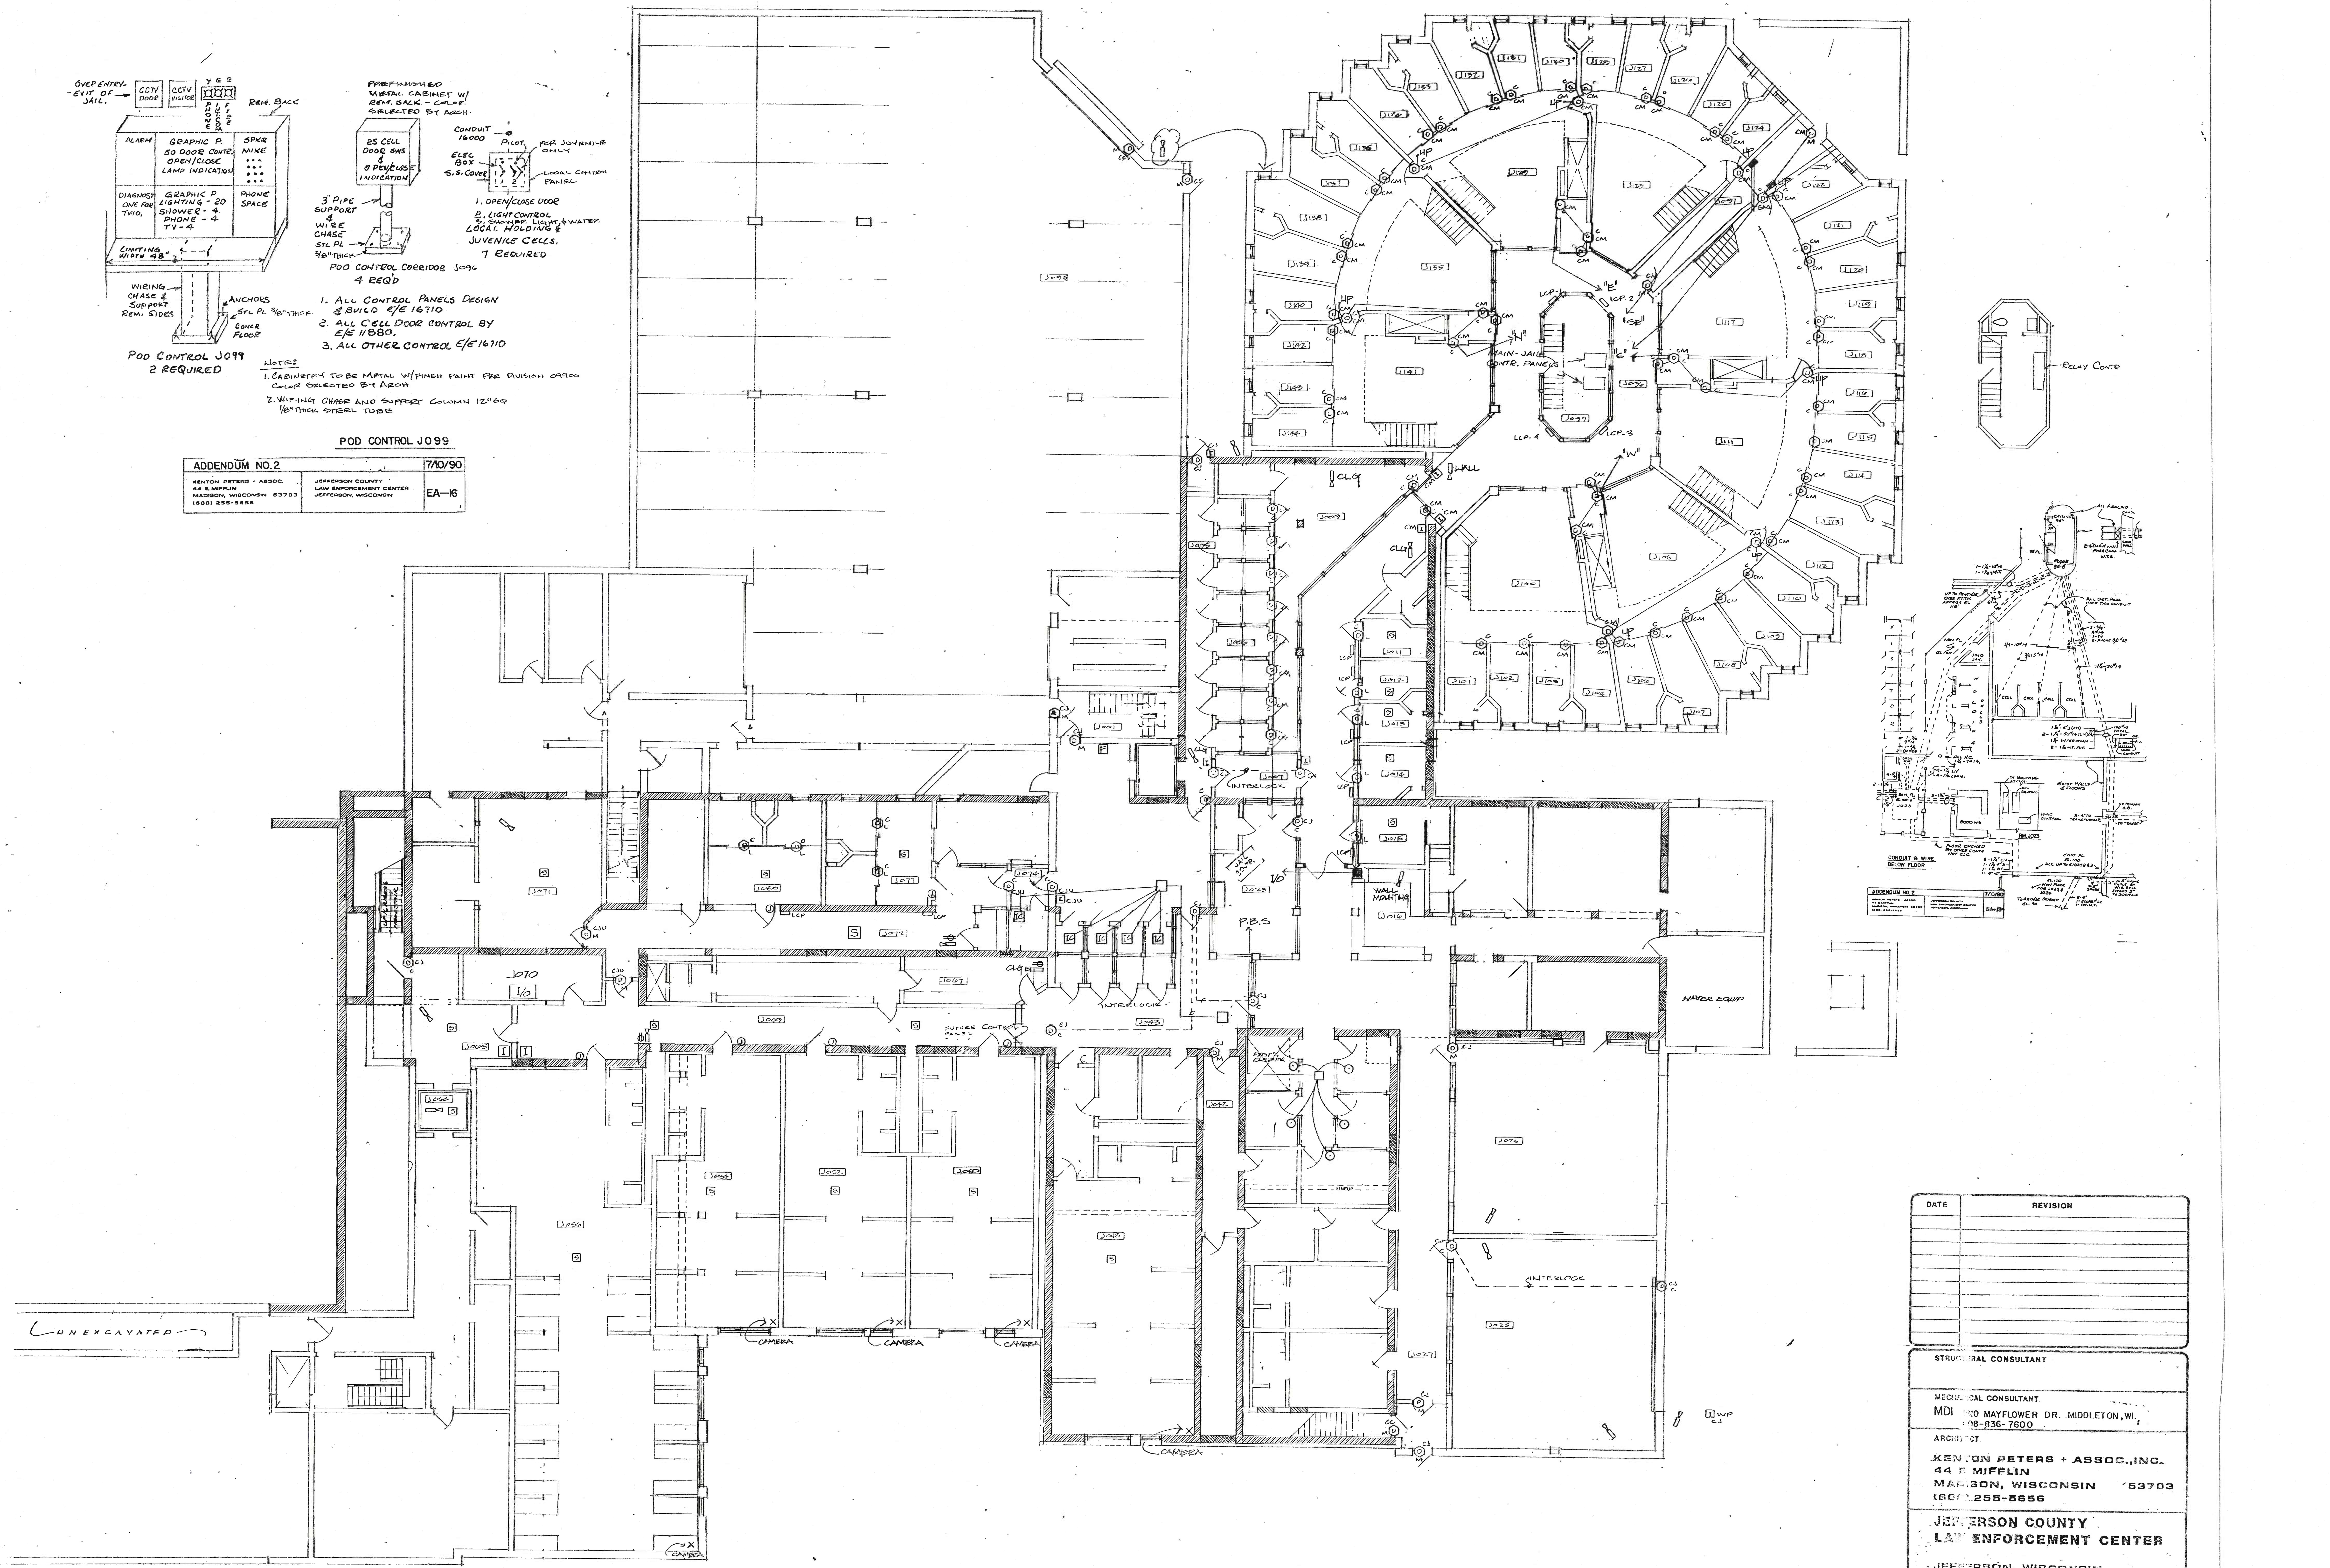


AS BUILT
DEC 6, 1994

DATE	REVISION

STRUCTURAL CONSULTANT

MECHANICAL CONSULTANT
MDI 310 MAYFLOWER DR. MIDDLETON, WI.
608-836-7600

ARCHITECT
KENTON PETERS + ASSOC., INC.
44 E MIFFLIN
MADISON, WISCONSIN 53703
(608) 255-5656

JEFFERSON COUNTY
LAW ENFORCEMENT CENTER
JEFFERSON, WISCONSIN

GROUND FLOOR PLAN
SECURITY

6-11-90
E-9